
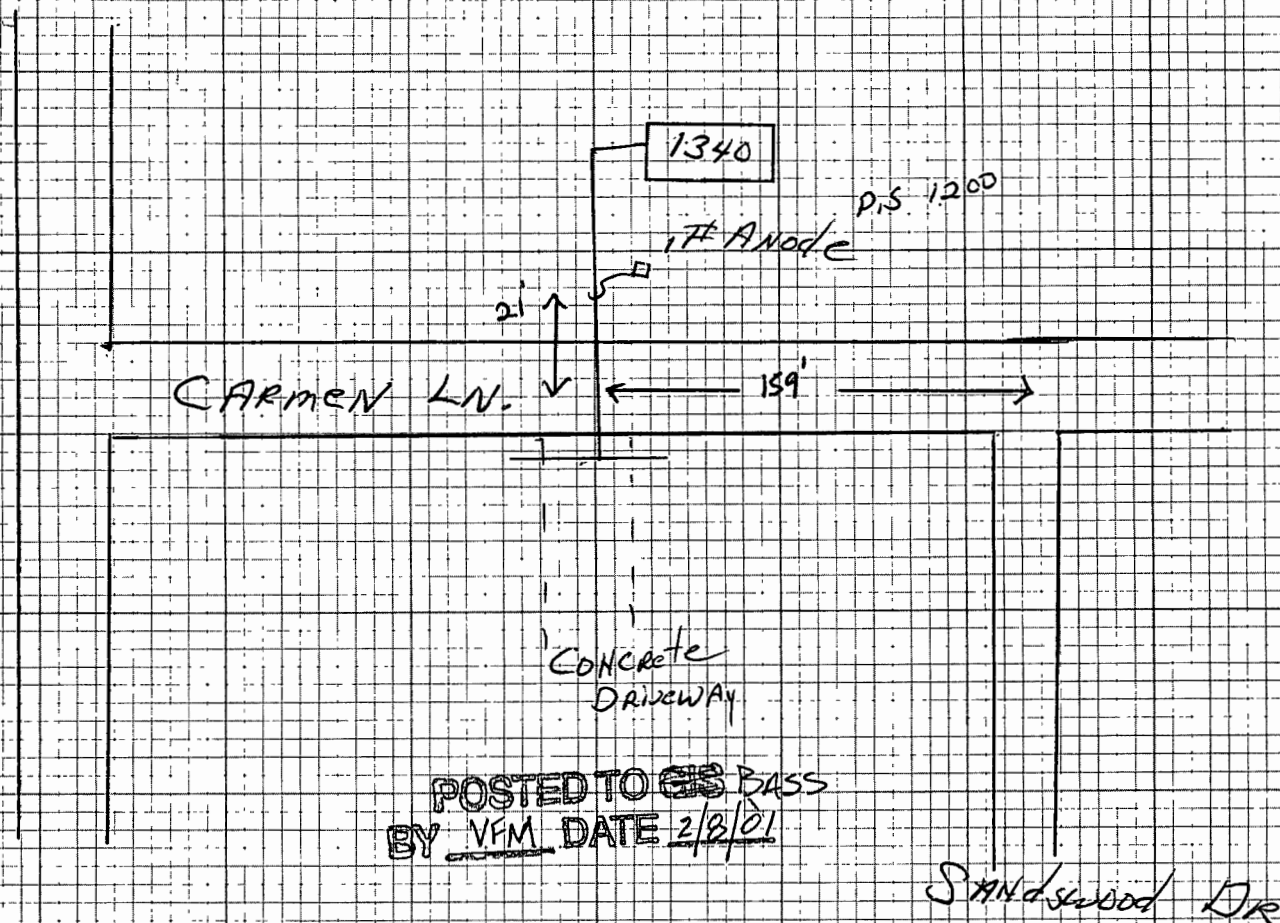


Churchill Dr

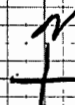

| PSNC ENERGY | | | | | AS-BUILT | | | |
|-------------|-----------|-----------|----------------|---------|--------------|---------|---------|---------------------|
| DRAWN BY: | S. Elmore | | STREET | | SIZE | TYPE | LENGTH | SIZE/TYPE OF ANODES |
| FUSION BY: | | | 1340 CARMEN LN | | 3 1/4" | CLW | | 1-17' Anode |
| TESTED BY: | | | | | | | | |
| WITNESS: | | | | | | | | |
| TEST PRESS. | DURATION | P/S READ. | CITY NO. | KEY NO. | GRID/SHT NO. | CP NO. | DATE | |
| | | 1200 | 700 | 56 | AK-32 | 1924 | 1-23-01 | |
| CITY | | | WORK ORDER NO. | UNIT | DEPT. | ACCOUNT | RES. | PROJECT ACT. |
| GASTONIA | | | 50110374 | | | 376.00 | | 26779 |