


POSTED TO ~~CIS~~ ~~BASS~~
BY VFM DATE 11/06/01

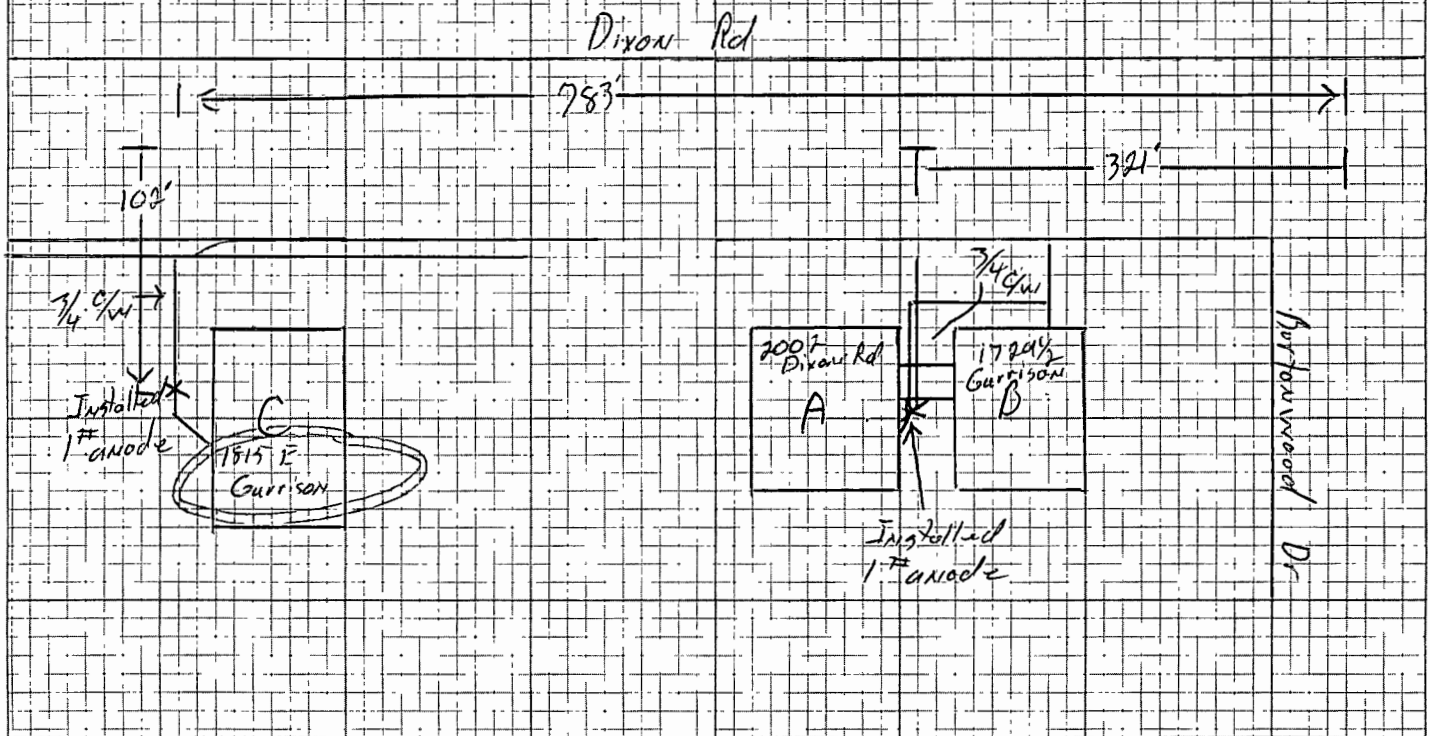

PSNC ENERGY					AS-BUILT				
DRAWN BY:	J Shuford		STREET		SIZE	TYPE	LENGTH	SIZE/TYPE OF ANODES	
FUSION BY:			Dixon Rd + Burtonwood		7/4	C/W		2-1"	
TESTED BY:									
WITNESS:									
TEST PRESS.	DURATION	P/S READ.	CITY NO.	KEY NO.	GRID/SHT NO.	CP NO.	DATE		
		650	700	56	AK-33	1417	10-12-01		
CITY			WORK ORDER NO.	UNIT	DEPT.	ACCOUNT	RES.	PROJECT	
Gastonia			50139783					0019264	
								ACT.	