


POSTED TO GIS
BY VFM DATE 1/2/01

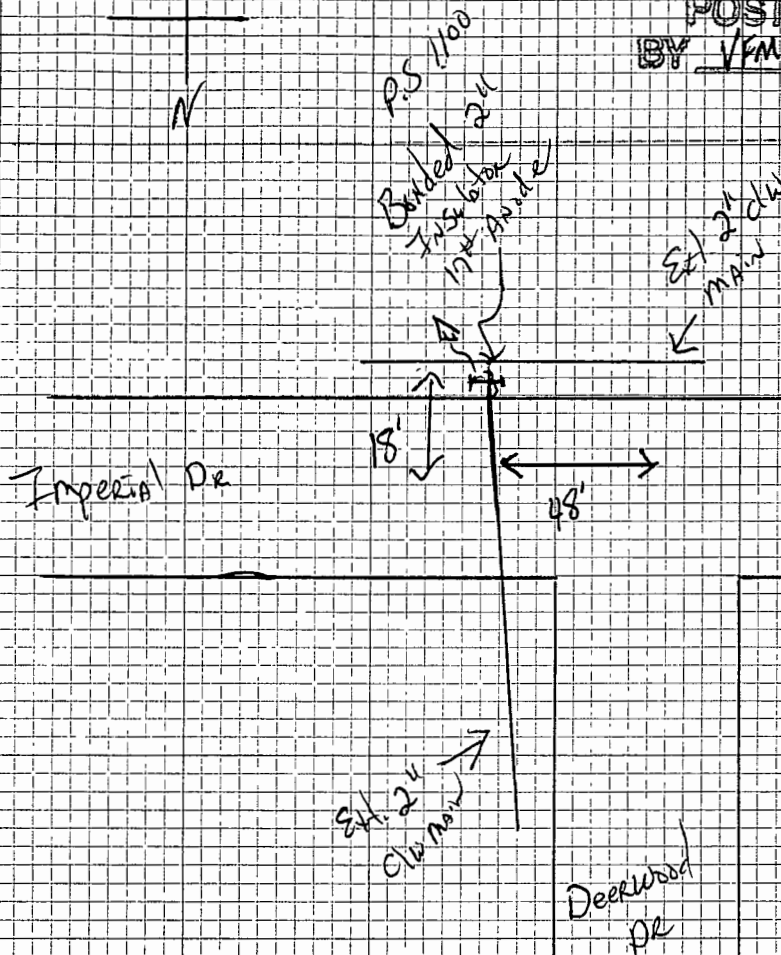

PUBLIC SERVICE COMPANY of NORTH CAROLINA, Inc.

AS-BUILT

| | | | | | | | | |
|-------------|-----------|-----------|------------------------|---------|----------|--------|----------------|---------------------|
| DRAWN BY: | S. Elmore | | STREET | | SIZE | TYPE | LENGTH | SIZE/TYPE OF ANODES |
| FUSION BY: | | | Imperial Dr / Deerwood | | 2" | clw | | 1-17" |
| TESTED BY: | | | | | | | | |
| WITNESS: | | | | | | | | |
| TEST PRESS. | DURATION | P/S READ. | K | LOC | ACCT | SUB | WORK ORDER NO. | DATE |
| | | 1100 | 1 | 177 | 376.00 | 031 | 50127120 | 4-9-01 |
| CITY | | | CITY NO. | KEY NO. | GRID NO. | CP NO. | PROJECT NO. | |
| Gastonia | | | 700 | 66 | AL-35 | 1921 | 26788 | |