

LOCATION 200 Dixon Cir.CITY GastoniaBETWEEN S. Maricatta ST.STREET & Dart Valley Dr.

STREET

	SIZE	TYPE	LENGTH	INSTALLED	RETIRED	RENEWED
MAIN TO BLDG.						
MAIN TO PROP. LINE						
PROP. LINE TO BLDG.						

ENTERS:

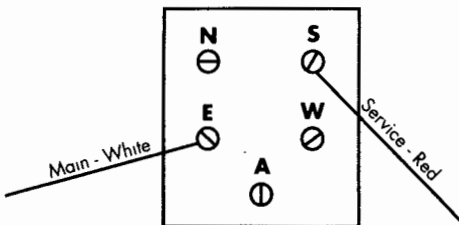
BRANCHED INTO:

TAP SIZE:

PRESSURE _____ PSI _____ INCHES W.C.

LOCATION

PRESSURE TEST: @ _____ PSI FOR _____ HRS. BY _____

MAIN-SIZE 2" C.I. _____ BARE STEEL _____ COATED STEEL ☒ PLASTIC _____ YEAR INSTALLED 1960DEPTH: 3' FT. 0 IN. LOCATION Dixon Cir."A" P/S READING 1.138 TOTAL ANODES 1# _____ 17# _____ L.R. # _____REMARKS: Bonded insulated 3/4" service tie to 2" Ctlw gas main. C.P. #1845Readings: .570 before bond and .930 after bond was made.

Test Station		
Reading & Location	Lead	Volts
P/S Pipeline Lead - Red New Service	S	
P/S Pipeline Lead - White Existing Main	E	

ENG. DEPT. USE ONLY